
## State of Wyoming Corner Record

CORNER PERPETUATION AND FILING ACT. Regulations of the Board of Registration for Professional Engineers and Land Surveyors.)

Reverse side of this form may be used if more space is needed.

Record of original survey and citation of source of historic information (if corner is lost or obliterated). Description of corner monumentation evidence found and/or monument and accessories established to perpetuate the location of this corner. Sketch of relative location of monument, accessories, and reference points with course and distance to adjacent corner(s) (if determined in this survey). Method and rationale for reestablishment of lost or obliterated corner.

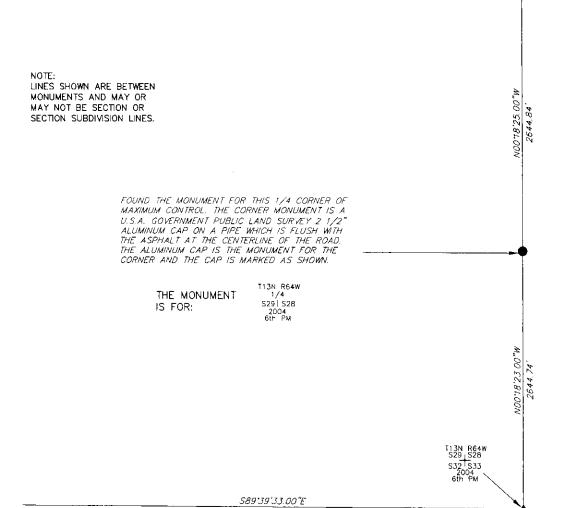

SSS T13N R64W 1/4 S29 | S28 2004 PLS 2500

THE MONUMENT IS MARKED

05/13/2010 Office Reference: Date of Field Work:\_

## CORNER MONUMENT SYMBOLS

- RECORD IS FOR THIS CORNER MONUMENT.
- A RELATED CORNER OR WC MONUMENT.

SCALE 1"=1000' CALE I = TOUU
(EXCEPT IN
TRIVIAL CASES)
BEARINGS ARE RELATED
TO WGS 84 WITH
GPS OBSERVATIONS
DRAWN BY: AM
P.C. L. PENCE

COUNTY: LARAMIE

CROSS INDEX DIAGRAM					
1 2 3 4	5 6 / 8 9	10 11 12 1	3 :4 15 16 1/	18 19 20 2	1 22 23 24 2
<b> </b>	_	- +			- + + -
L_i_k. i _			L _! _ \d! _ d		
, , , , , , , , , , , , , , , ,	i . i . i . i . i . i . i . i . i	1	1 1 4 1	1 6 1	_ T _ ! _ [
1		- + -:- + -		-+	-++
<del>                                      </del>	+ + +	+++	+ + + +	+++	
h - ' - h - i -	▎ <del>▘</del> ┝			<b>-</b> ├ ├ ├-	r + -¦- + ·
I -1 - 7 - + -	— + 8 —i — <del> </del>	- <del></del> -9- <del>-</del> -		11-j-l	- + 12-+
	_ <del> </del> _	ـ ــا ـــنـــ اــــــــــــــــــــــــ		_	
1 1 1		1 1 1		1 1 1	
		1 1 1	1 1	1 1	
1-1-1-	- - -	- +			_ + +
1-18 -		- + -16		- <del> </del> 14- -	r + -1[3- <del> </del> -
F-1-1-	╎╼╶ <del>╎</del> ╾┡	- + -:- +	├ <del>─</del> त्रे <del>का हे</del> ल्हे		
1-1-1-	_ i_ i _ i_	- + -, - + -		_ i_ i	
سالم مادران		1.01.		_ [_ ]	L 1. 3. L.
L - L - L - L -		- 14 i L	[ -1 -42 -1 -]	_1, 42_1_	7 4 7
		- +/ +			-+
<del> </del>		1 1 1			111
1-1	— <del> -</del>	- + -;- + -	├ <b>¦ ├</b> - <b> </b>	- <del> -</del> + - -	
	- <del>- 2</del> 9-j-	+ 28-+-	-1-27 -	- <u>i</u> - 26-i-	- + ·25- <del>-</del> ·
L i	_	- <del> </del>   -i -   -	لنالنا	_	_ 4 _ 4 _ 4 .
1 1 1		1 1 1	1 1 1	1	1 1 1
		T 1		<u> </u>	
1		- <del> </del>			_ + -:- + -

Firm/Agency, Address

UELS, LLC


85 South 200 East

Vernal, Utah 84078

Telephone Number: 435-789-1017

This corner record was prepared by me or under my direction by me or under and supervision.

SEAL & SIGNATURE

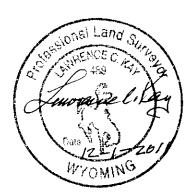

## 

RECORDED 12/08/2011 AT 1:16 PM REC# 581069 BK# 2249 PG# 395

Corner Name: EAST 1/4 CORNER OF SECTION 29

Section: \_

29 T 13N R 64W ; 6TH P.M. Cross Index No.: T-9